


BULLY BOY



HUNGRY BOARDS  
AS BUILT – BULLY BOY

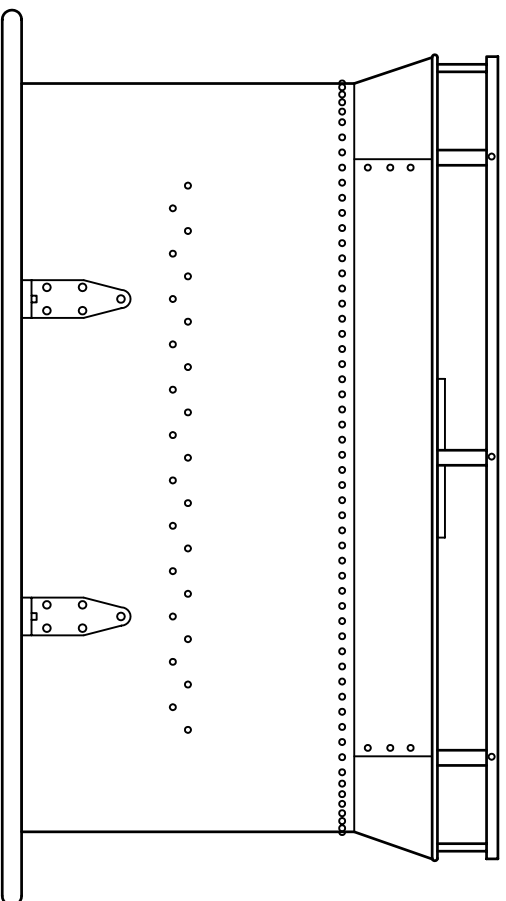